



scale 1:75 DAO	drawn by JL	checked by CD	date DEC'09	drawing no. C4439-RD3
----------------------	----------------	------------------	----------------	--------------------------





scale 1:75 ②AQ	drawn by JL	checked by CD	date DEC'09	drawing no. C4439-RD4
----------------------	----------------	------------------	----------------	--------------------------

LEGEND

- LIGHTING BUSBAR
 --- REFRIG. PIPE
 --- CONDENSATE PIPE
 --- HWS
 --- CWS
 --- WASTE PIPE
 [Symbol] EXTRACT GRILL
 (600mm x 600mm)
 [Symbol] SUPPLY GRILL
 (600mm x 600mm)

VOLUME (l/s)	DUCT DIA. (mm)
VELOCITY (m/s)	PRESSURE (pa)

NOTE
ELECTRIC PANEL HEATERS
ARE SUPPLIED & INSTALLED
BY ELECTRICAL CONTRACTOR

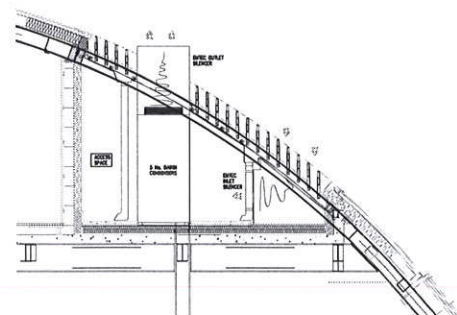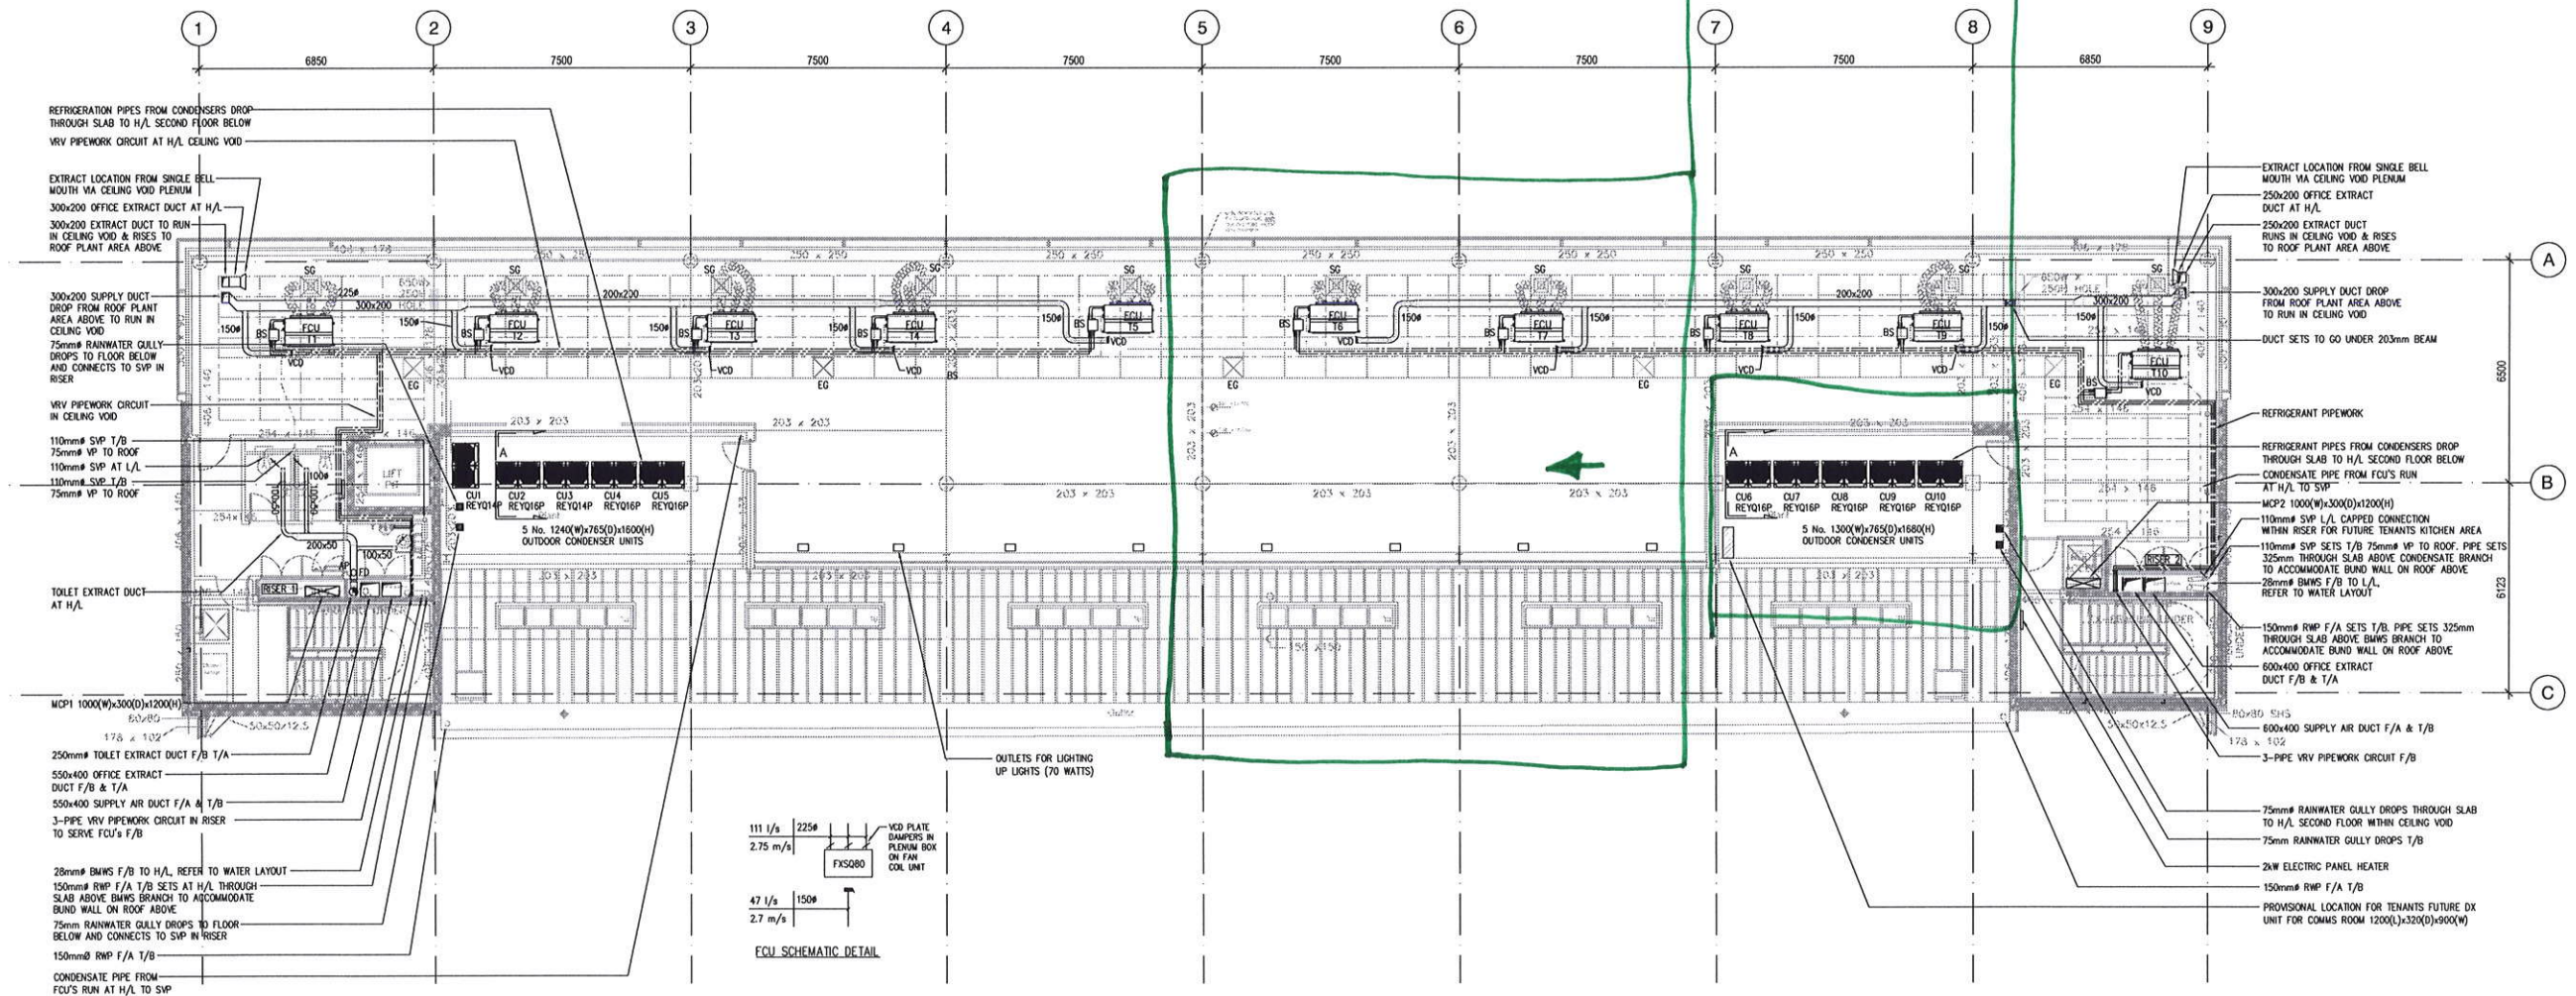

SECTION A:A

RECORD DRAWING

ELMSTEAD MECHANICAL SERVICES

1st Floor - Bates Business Centre
 The Old Brickworks, Church Road
 Harold Wood, Essex RM3 0JF
 Tel. 01708 378987
 Fax. 01708 371836
 E-Mail info@elmstead.co.uk



project 7-11 HESTER ROAD

title 3RD FLOOR MECHANICAL SERVICES LAYOUT

scale 1:75@A0	drawn by JL	checked by CD	date DEC'09	drawing no. C4439-RD5
---------------	-------------	---------------	-------------	-----------------------