


NOTES:-

- 1 FOR CO-ORDINATED SECTIONS REFER TO EWS DRAWING NO. C4149/M2/20 + M223

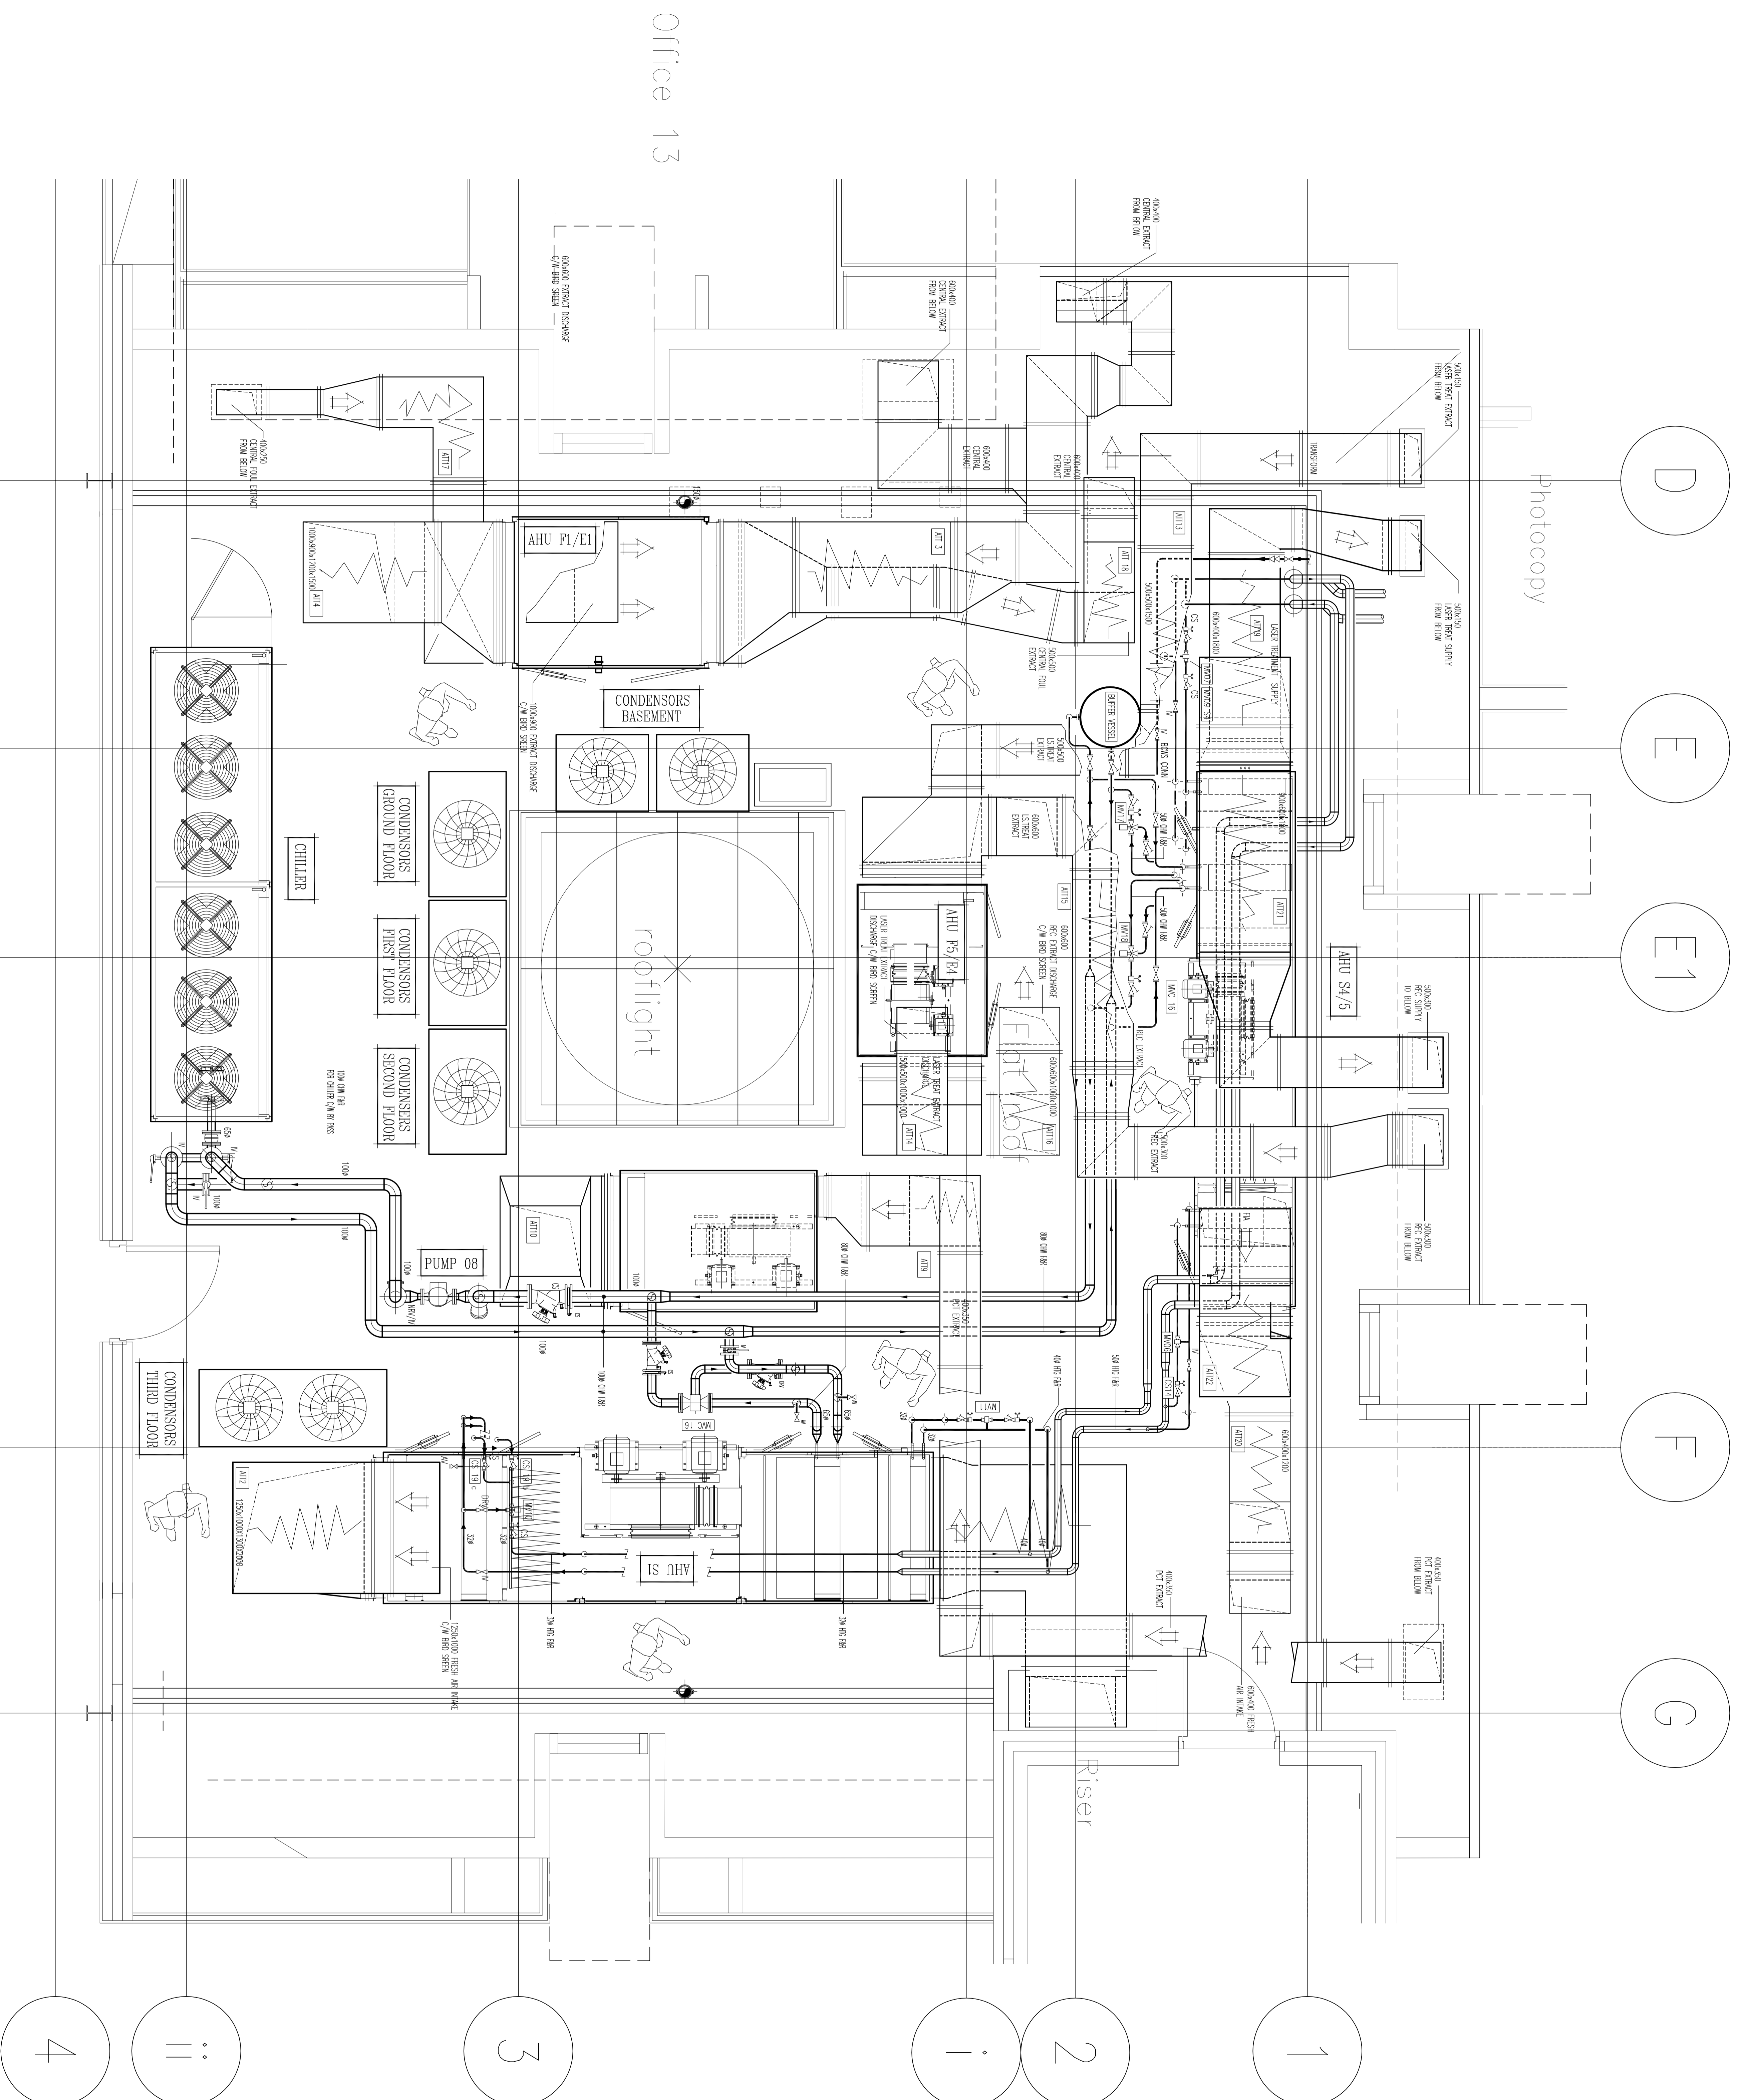


RECORD DRAWING

no	details	date
RD	RECORD DRAWING ISSUE	DEC 07

ELMSTEAD MECHANICAL SERVICES

Regis House, 42b Homestead Road,
Bromley, Kent BR2 9LD.
Tel: 020-8230 0317
Fax: 020-8484 8338
E-Mail: info@elmstead.co.uk

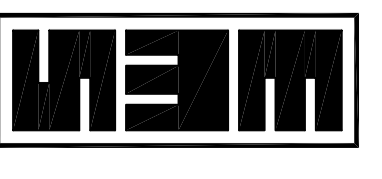

Project	BRAMPTON HOUSE REDEVELOPMENT
Title	ROOF LEVEL PLANTROOM MECHANICAL CO-ORDINATED SERVICES
Scale	1:25
Drawn by	CCS
Checked by	RV
Date	DEC 07
Drawing no.	C4149/M019-RD