General Notes

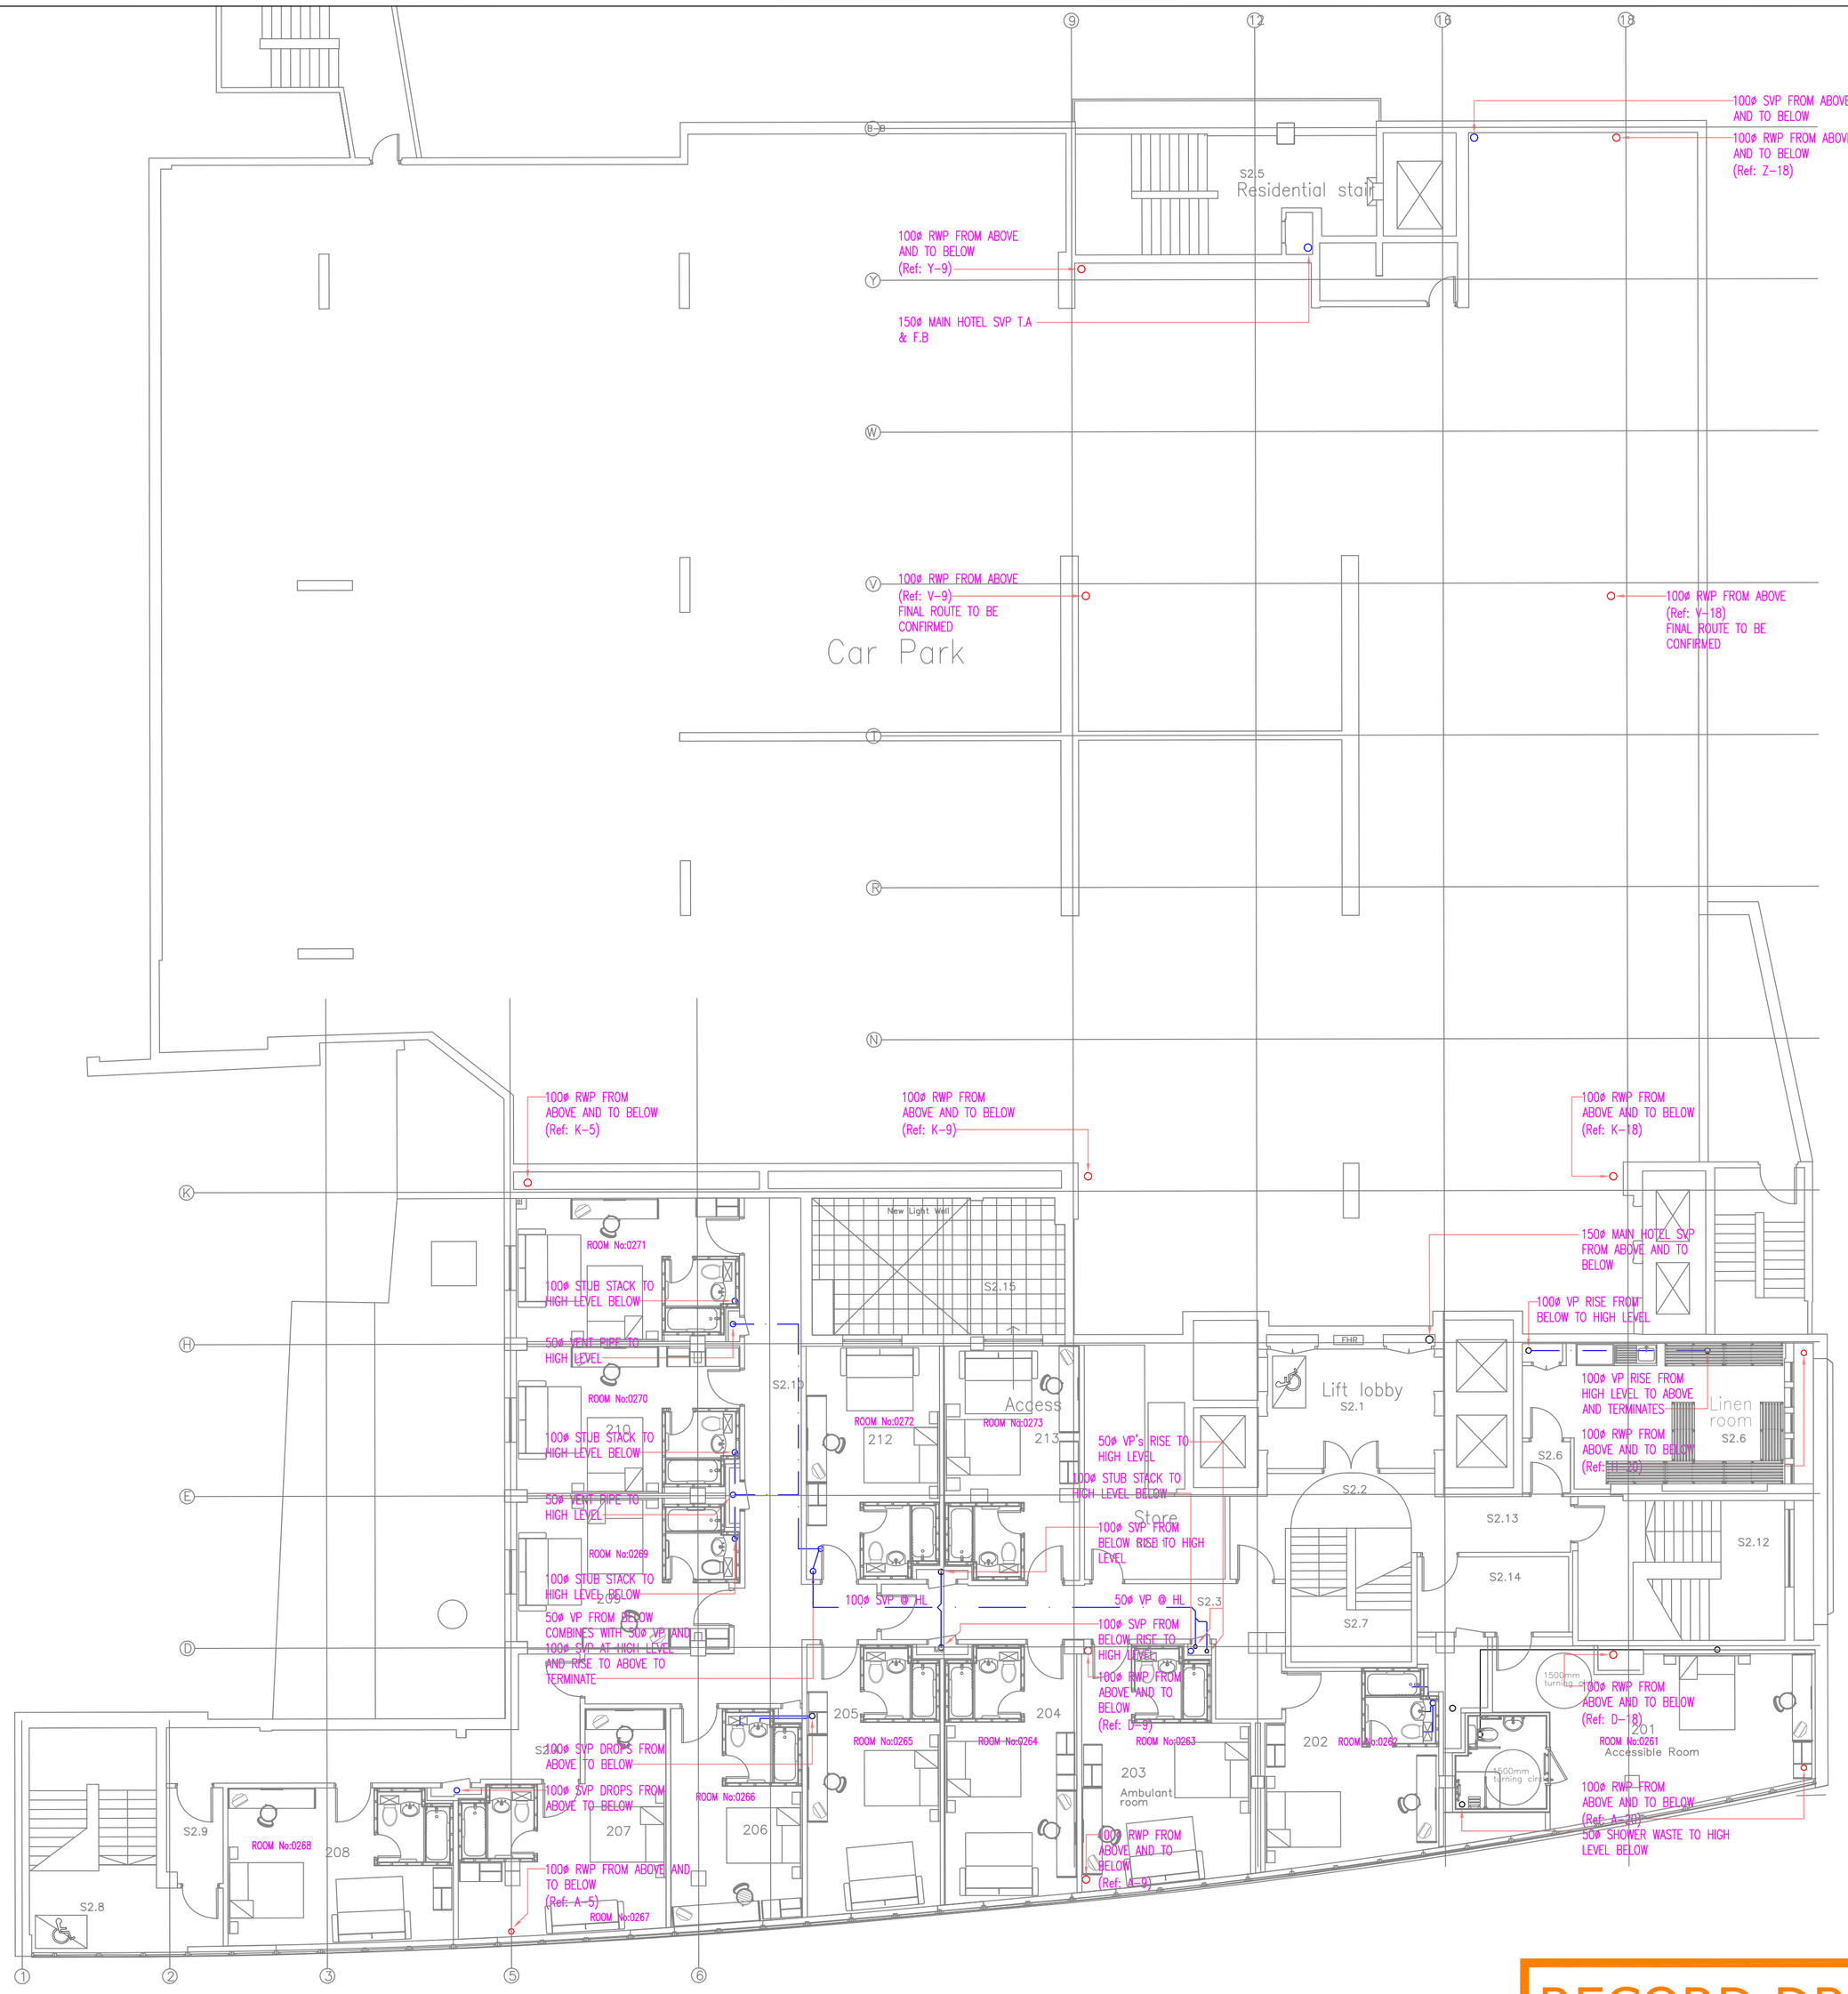

RECORD DRAWING

rev	details	date

ELMSTEAD MECHANICAL SERVICES

Regis House, 42b Homesdale Road,
Bromley, Kent BR2 9LD.

Tel. 020-8290 0317
Fax. 020-8464 8358
E.Mail info@elmstead.co.uk

client: Travelodge GallifordTry

project: COVENT GARDEN TRAVELODGE EXTENSION

title: SECOND FLOOR SANITARY PIPEWORK LAYOUT

scale	drawn by	checked by	date	drawing no.
1:100 @A1	TS	CS	APR'06	C3854-RDPH205